

Handouts: copy of the POR TEPPL; copy of complete POR package.

Received 582 PORs in the last year

Division 13 sent in the most pors – 128; Div 11 2<sup>nd</sup> with 92

### **Audience participation:**

There are 3 possible answers to each question:

- 1) New plan
- 2) Plan of record
- 3) No plan needed

Cabinet is located in a different quadrant – plan of record

6x60 loop is replaced with a 6x40 quadrupole loop – plan of record

Time before reduction is increased – no plan needed

Right turn overlap is added – new plan

Change from 5-phase to 2-phase – new plan

Change max time – no plan needed

Change min time – no plan needed

Upgrade from 8” to 12” heads – plan of record

Upgrade to LEDs – no plan needed

Upgrade from pretimed to semi-actuated – new plan needed

Replace Tee head with 3-section all arrow head – plan of record

Change delay on a loop from 15 seconds to 20 seconds – no plan needed

Revise FYA head from flashing red to flashing yellow during flashing operation – plan of record

Change from stretch detection to volume density – new plan

Upgrade from NEMA controller/cabinet to 2070 – plan of record

Change in speed limit – new plan

Change in clearance times – new plan

Upgrade to countdown ped heads – plan of record

Change from 5-phase to 8-phase – new plan

Move stop bars further back from their original plan location – new plan

Move stop bars closer to intersection from original plan – plan of record

Remove backplates that were shown on original plan – plan of record

If you're not sure, call your regional signals engineer or Buddy Murr.

### **Here are some of the issues we run into:**

Lanes don't match

Marked up signal plan not sent in even though there have been changes

Need speed limits

Street names and SRs have changed

Stretch time in quarter seconds rather than tenths for 2070 plans

Mark up the correct plan, sometimes we get an older version even though the newer one is installed

Conflicting information

Complete and correct loop info

Label loops


Loop information on the signal plan contradicts the information on the electrical details

No info on backup protection


Make sure it's legible

STATE	PROJECT NO.	SHEET NO.	TOTAL SHEETS
N.C.	6,327014	SIG. I	I
F.A. PROJ. NO.			


# PHASING DIAGRAM

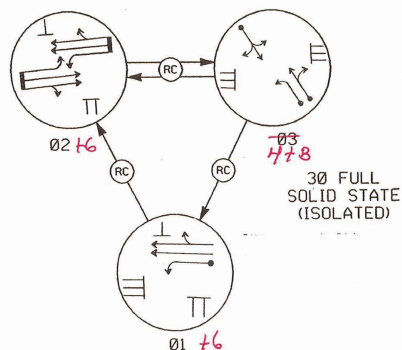

# SIGNAL FACE I.D.

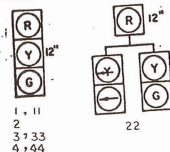


# ADT COUNT

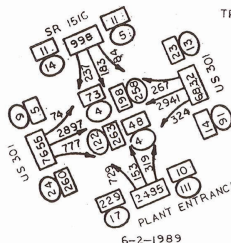

PEAK HOUR 4:45 P.M.  
TRKS 325

# LEGEND

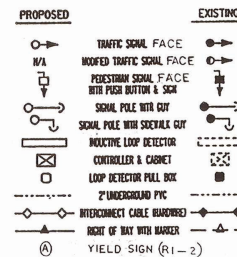

- NOTES
- NEW INSTALLATION
  - NEW POLES TO BE LOCATED AS SHOWN ON PLANS
  - CABINET SHOULD BE PLACED SO AS NOT TO OBSTRUCT SIGHT DISTANCE OF VEHICLES TURNING RIGHT ON RED.
  - CONTROLLER SHOULD BE PROGRAMMED TO START UP IN PHASE 2, 7, 8
  - ALL UNDERGROUND UTILITIES AND CULVERTS SHOULD BE LOCATED PRIOR TO POLE DRILLING AND CONDUIT TRENCHING.
  - ONLY 91 DURING 62 GREEN.
  - STANDARD TO FLASH FROM 11:00 PM TO 5:00 AM UNLESS OTHERWISE DIRECTED BY AREA TRAFFIC ENGINEER.


# COLOR SEQUENCE CHART

SIGNAL FACE	02		03		01		FLASH
	R/W	CLEAR	R/W	CLEAR	R/W	CLEAR	
1, 11	G	Y	R	R	R	R	Y
2	G	Y	R	R	R	R	G
22	G	Y	R	R	R	R	G
3, 33	R	R	G	Y	R	R	R
4, 44	R	R	G	Y	R	R	R

# TIMING CHART



PHASE	02 16	03 178	01 14
MINIMUM GREEN	10 SEC.	7 SEC.	7 SEC.
PASSAGE/GAP	2 SEC.	2 SEC.	1 SEC.
YELLOW CLEARANCE	4.5 SEC.	5.0 SEC.	4.0 SEC.
RED CLEARANCE	1.5 SEC.	1.3 SEC.	1.0 SEC.
MAX. 1	4.5 SEC.	2.0 SEC.	1.5 SEC.
RECALL POSITION	MIN. RECALL	NONE	NONE
VEHICLE CALL MEMORY	LOCK	NON-LOCK	NON-LOCK

STOP BARS  
AS SHOWN ON NASH CO.  
GPS

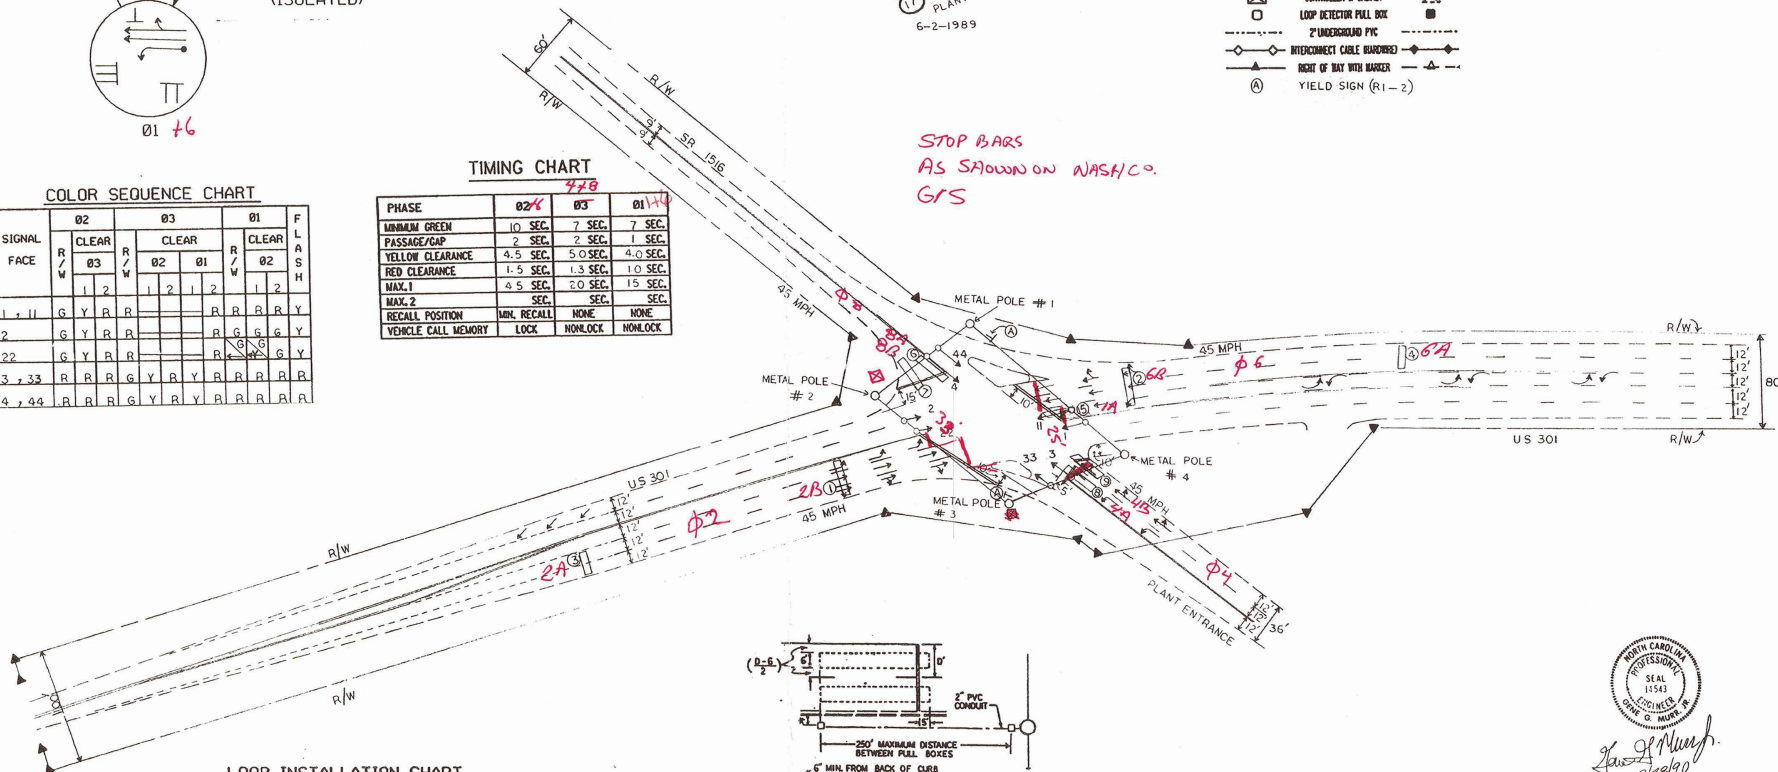

# LOOP INSTALLATION CHART

LOOP NO.	SIZE	TURNS	DIST. FROM STOPBAR	FUNCTION	ATTACHED TO AMPLIFIER NO.	SPECIAL FEATURES	AMPLIFIER TANK DELAY/STATION	LOOP DETECTOR STATUS
1	6' X 32'	2	90'	02	1		SEC.	NEW
2	6' X 32'	2	90'	02	1		SEC.	NEW
3	6' X 20'	2	330'	02	2	STRETCH	2 SEC.	NEW
4	6' X 20'	2	330'	02	2	STRETCH	2 SEC.	NEW
5	6' X 60'	2-4	+5'	01	3		SEC.	NEW
6	6' X 60'	2-4	+5'	03	4		SEC.	NEW
7	6' X 60'	2-4	+5'	03	4		SEC.	NEW
8, 9	6' X 60'	2-4	+5'	03	5		SEC.	NEW

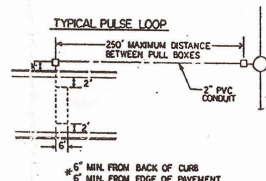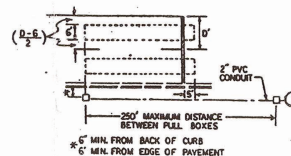

# NEW INSTALLATION

US 301 AND SR 1516 AND PLANT ENTRANCE  
AT CONSOLIDATED DIESEL COMPANY

DIV. 04	NASH CO.	S.O.F. WHITAKERS
DATE: 7/1/90	N.C. DEPARTMENT OF TRANSPORTATION	REVISION:
DRAWN BY: M.B.	DIVISION OF HIGHWAYS	
DESIGNED BY: M.B.	TRAFFIC ENGINEERING BRANCH	
APPROVED:		

# 2070 EQUIPMENT INFORMATION

( Circle or fill in information )

CABINET MANUFACTURER	McCain	EAGLE	SAFETRAN	PHILLIPS/SISSON	TEMPLE
CONTROLLER	EAGLE	ECONOLITE	SAFETRAN	NAZTEC	
CABINET / (MODEL*)	M11469				
SOFTWARE	ECONOLITE (OASIS) / OTHER				
CABINET MOUNT	BASE / POLE				
OUTPUT FILE POSITIONS	12 / 18(12-STD, 6-AUX)				
LOAD SWITCHES USED	LS1, LS2, LS4, LS6, LS8				
PHASES USED	1, 2, 4, 6, 8				
OVERLAP A:	OVERLAP B:	OVERLAP C:	OVERLAP D:		
CABINET PRINT	YES / NO , DRAWING NUMBER				
EXISTING ELECTRICAL DETAIL	YES / NO				
AUX. DEVICES (GPS, MICROWAVE, ...)					

# 2070 PLAN OF RECORD

RECORDED BY Steven Hoag

TIME AND DATE Feb 5 09

SIGNAL INVENTORY NUMBER 04-0469

INTERSECTION US 301 @ SR1516 and Plant Ent. Consolidated

DIVISION 4 COUNTY Nash CITY Whitakers

# INPUT FILE CONNECTION & PROGRAMMING CHART

LOOP NO.	LOOP TERMINAL	INPUT FILE POS.	NEMA PHASE	CALL	EXTEND	FULL TIME DELAY	STRETCH TIME	DELAY TIME
1A	TA1-1,2	11U	1	Y	Y			15
		11L		Y	Y			
2A	TA2-5,6	12U	2	Y	Y		2.0	
2B	TA2-7,8	12L	2	Y	Y			
		13U		Y	Y			
		13L		Y	Y			
		14U		Y	Y			
		14L		Y	Y			
		15U		Y	Y			
		15L		Y	Y			
4A	TA4-9,10	16U	4	Y	Y			3
4B	TA4-11,12	16L	4	Y	Y			15
		17U		Y	Y			
		17L		Y	Y			
		18U		Y	Y			
		18L		Y	Y			
		19U		Y	Y			
		19L		Y	Y			
		20U		Y	Y			
		20L		Y	Y			
6A	TA6-5,6	21U	6	Y	Y		2.0	
6B	TA6-7,8	21L	6	Y	Y			
		22U		Y	Y			
		22L		Y	Y			
		23U		Y	Y			
		23L		Y	Y			
		24U		Y	Y			
		24L		Y	Y			
		25U		Y	Y			
		25L		Y	Y			
8A	TA8-9,10	26U	8	Y	Y			
8B	TA8-11,12	26L	8	Y	Y			5
		27U		Y	Y			
		27L		Y	Y			
		28U		Y	Y			
		28L		Y	Y			
		29U		Y	Y			
		29L		Y	Y			


# SIGNAL HEAD HOOK-UP CHART

LOAD SWITCH NO.	S1	S2	S2P	S3	S4	S4P	S5	S6	S6P	S7	S8	S8P	S9	S10	S11	S12	S13	S14
PHASE	1	2	2 PED	3	4	4 PED	5	6	6 PED	7	8	8 PED	DLA	DLB	SPARE	DLA	DLB	SPARE
SIGNAL HEAD NO.	22	1,11			4,44			2			3,33							
RED		123			101			134			107							
YELLOW		124			102			135			108							
GREEN		132			103			136			109							
RED ARROW																		
YELLOW ARROW	126																	
GREEN ARROW	127																	

# CONFLICT MONITOR MODEL # 2010 ECL 040802724 HCK

Remove diode jumpers: 1-6, 2-6, 4-8

Circle switch positions:  
Ex: If Phase 1 switch is ON PHASE SWITCH 11 OFF / ON

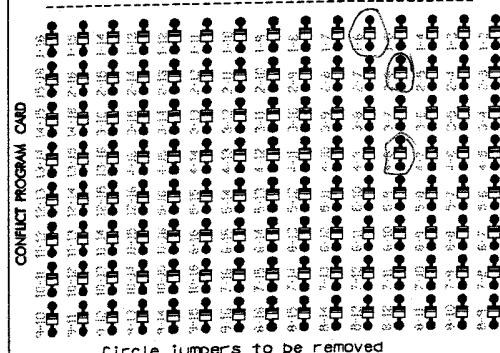


## PHASE SWITCH

1	OFF / ON
2	OFF / ON
## OPTIONS

OFF / ON	RF 2010
OFF / ON	RF DISABLE
OFF / ON	WD 1.0 SEC
OFF / ON	GY ENABLE
OFF / ON	POLARITY
OFF / ON	YEL TIME-1
OFF / ON	YEL TIME-2
OFF / ON	YEL TIME-3

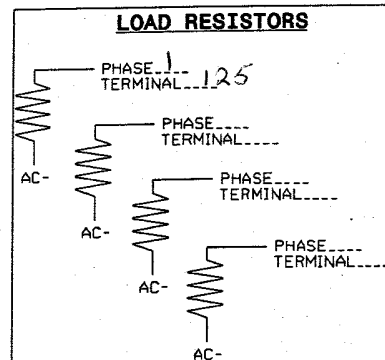

Back up Protection  
For 21 Programs